



RELATIONSHANDLING

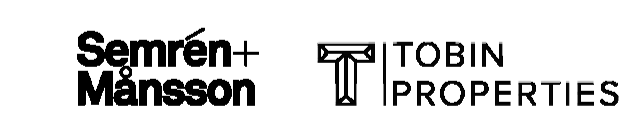

A	SEMRÉN & MÅNSSON	TEL: 08-459 37 00
K	KJAB	TEL: 018-10 03 90
E	IKKAB	TEL: 08-556 965 80
V	PROJEKTENGEMANG	TEL: 08-522 069 00
W	PROJEKTENGEMANG	TEL: 08-522 069 00
L	URBIO	TEL: 08-658 99 38

LUPPROG NR 2123	RITAD AV PL,FB,AE,MA	HANDLAGGARE A EKMAN
DATUM 2019-06-07	ANSVARIG ANDERS EKMAN	

NORRA DJURGÅRDSSTADEN, STOCKHOLM
FLERBOSTADSHUS
HUS 1, PLAN 13, DEL 11

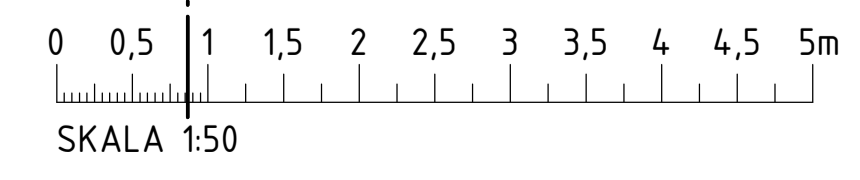

SKALA A1 1:50 A3 1:100	NUMMER A1-40-1-11311	BET
------------------------------	-------------------------	-----