


C:\Users\semandekm\Documents\A_2123_Brofastet_R16_C_semandekm.rvt
2019-06-07 11:22:12



| BET | ANT | ÄNDRINGEN AVSER | SEEN | DATUM |
|----------------------------------|------------------|-------------------------|---------------|-------------|
| BROFÄSTET B11 | | | | |
| | | | | |
| RELATIONSHANDLING | | | | |
| Semrén+Månsson | | TOBIN PROPERTIES | | |
| A | SEMRÉN & MÅNSSON | TEL: | 08-459 37 00 | |
| K | KJAB | TEL: | 018-10 03 90 | |
| E | IKKAB | TEL: | 08-556 965 80 | |
| V | PROJEKTENGEMANG | TEL: | 08-522 069 00 | |
| W | PROJEKTENGEMANG | TEL: | 08-522 069 00 | |
| L | URBIO | TEL: | 08-658 99 38 | |
| LUPPROG NR | 2123 | RITAD AV | PL,FB,AE,MA | HANDLAGGARE |
| DATUM | 2019-06-07 | ANSVARIG | ANDERS EKMAN | A EKMAN |
| NORRA DJURGÅRDSSTADEN, STOCKHOLM | | | | |
| FLERBOSTADSHUS | | | | |
| HUS 2, PLAN 12, DEL 22 | | | | |
| SKALA | A1 1:50 | NUMMER | A1-40-1-21222 | |
| | A3 1:100 | | I BET | |

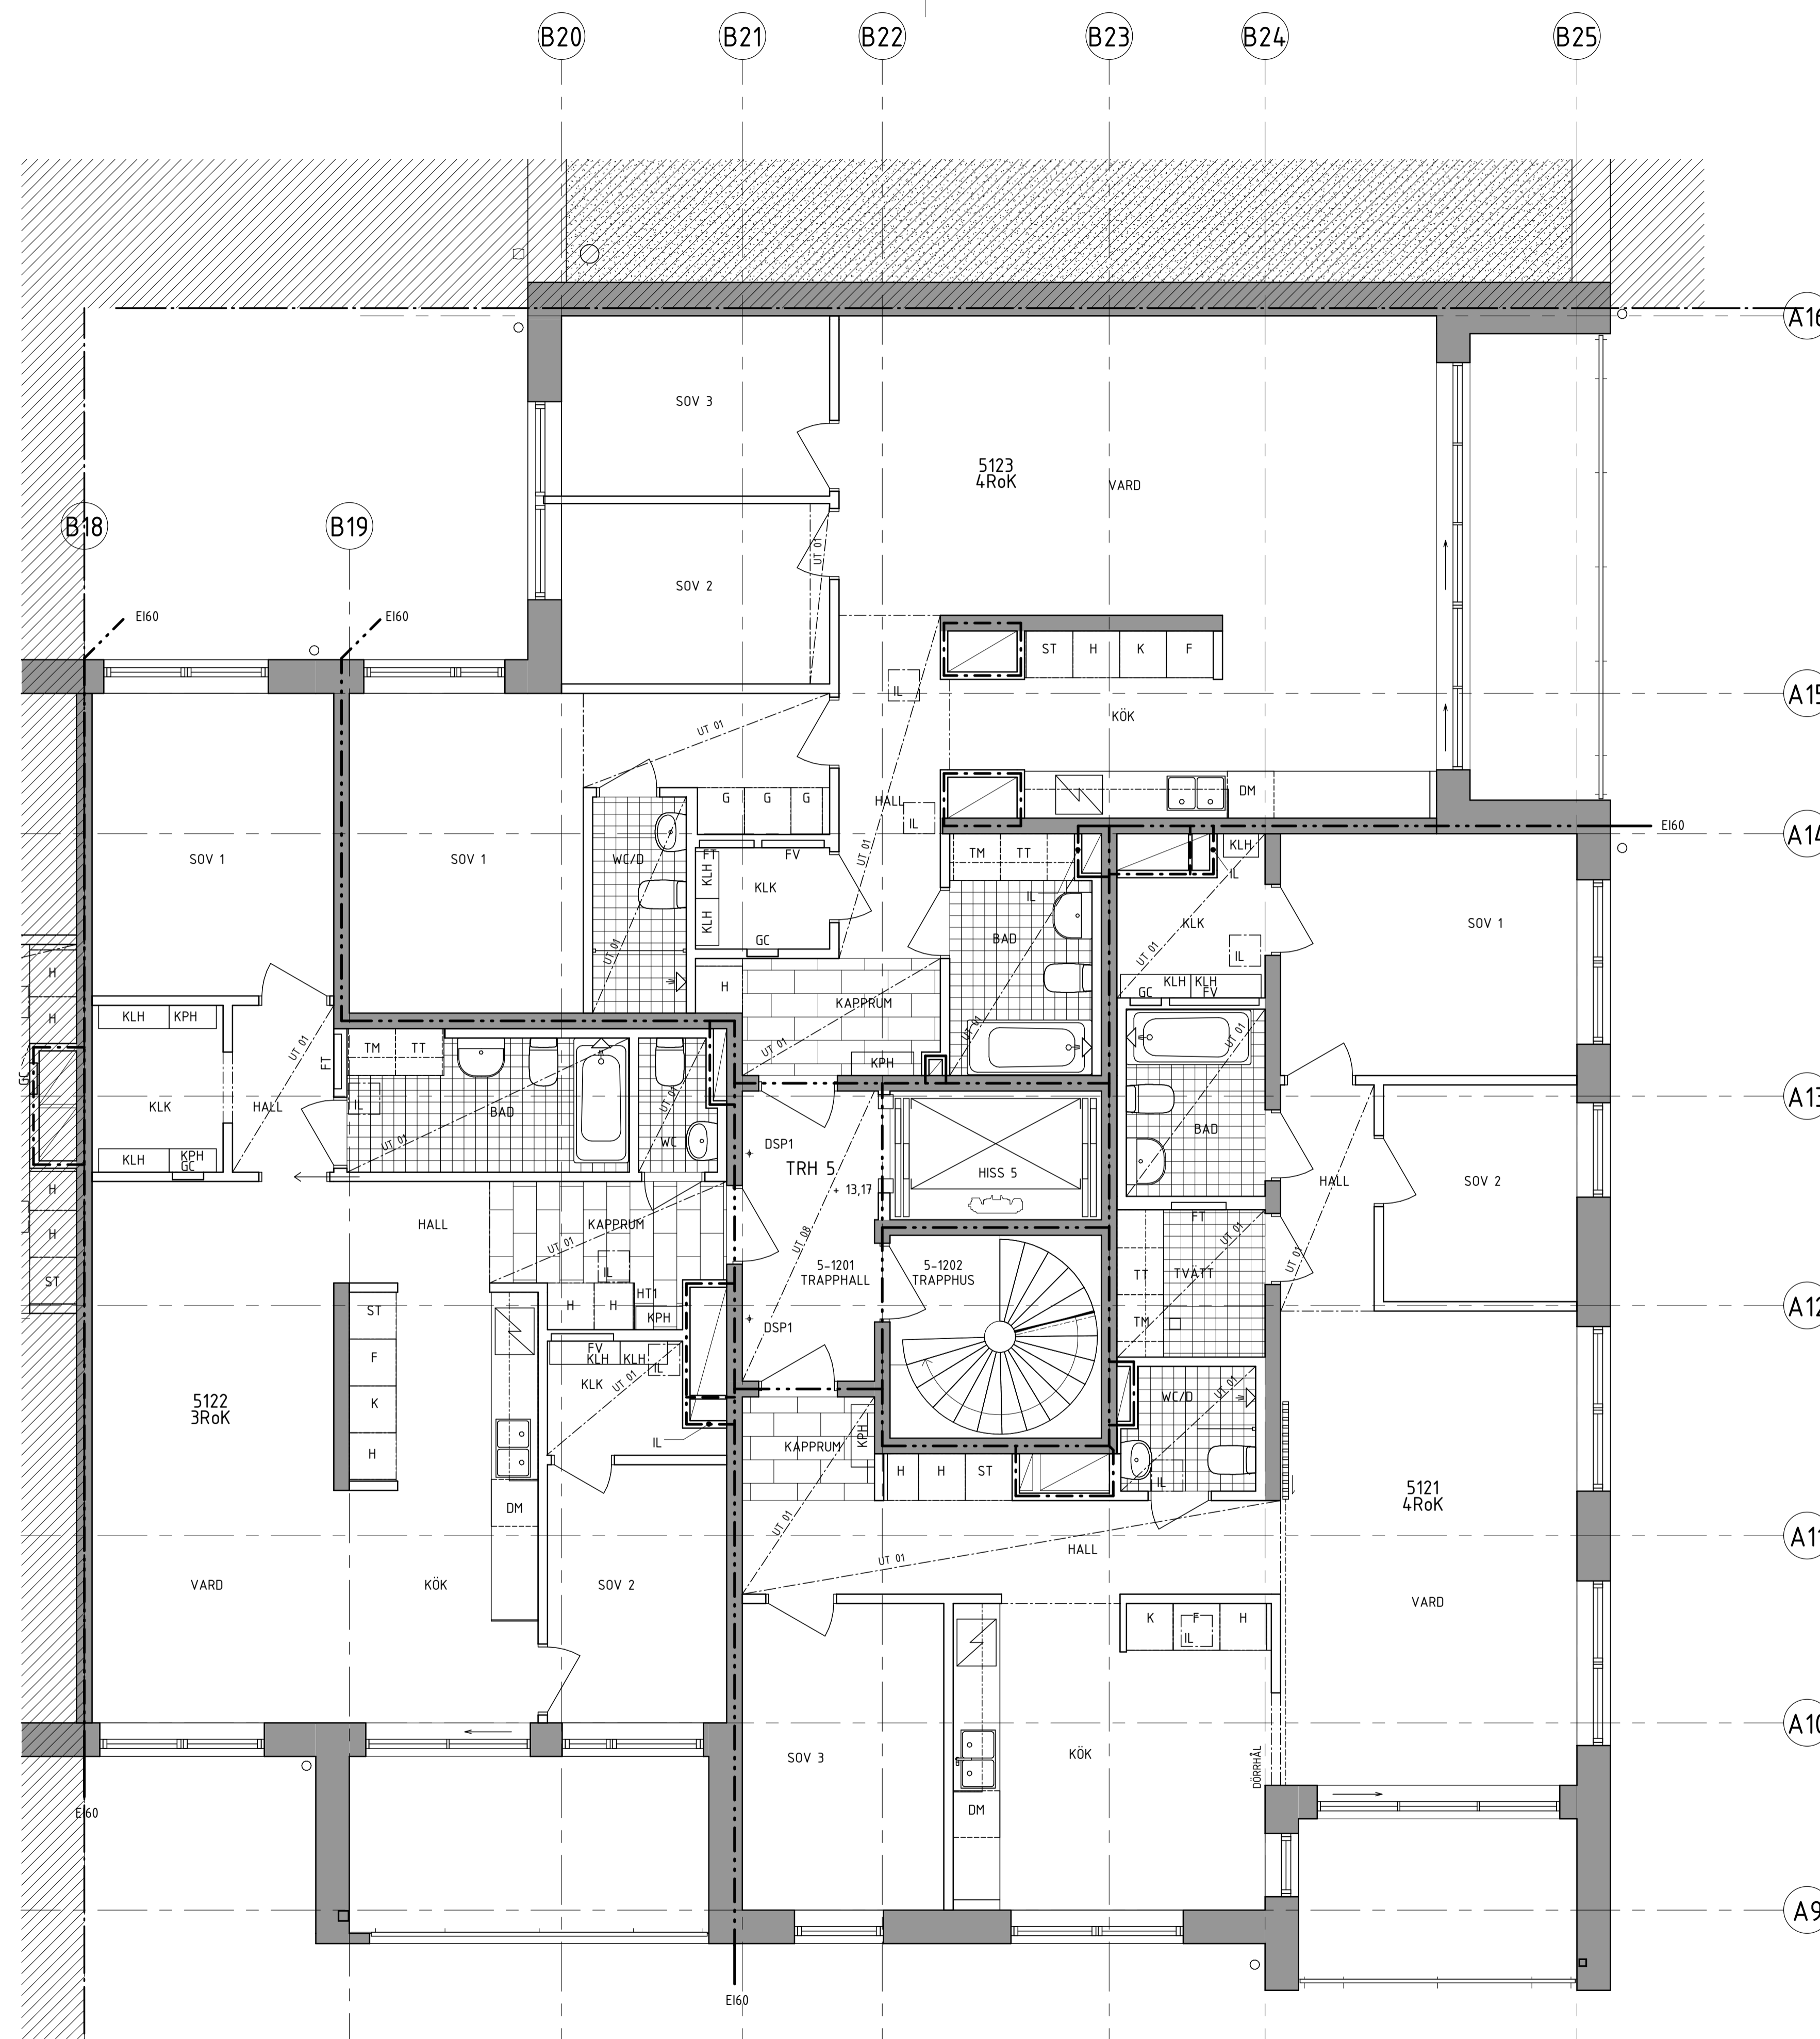