

B20

B21

B22

B23

B24

B25

HÄNVISNINGAR
SE RITNING A1-40-0-0001

A16

A15

A14


A13

A12

A11

A10

A9

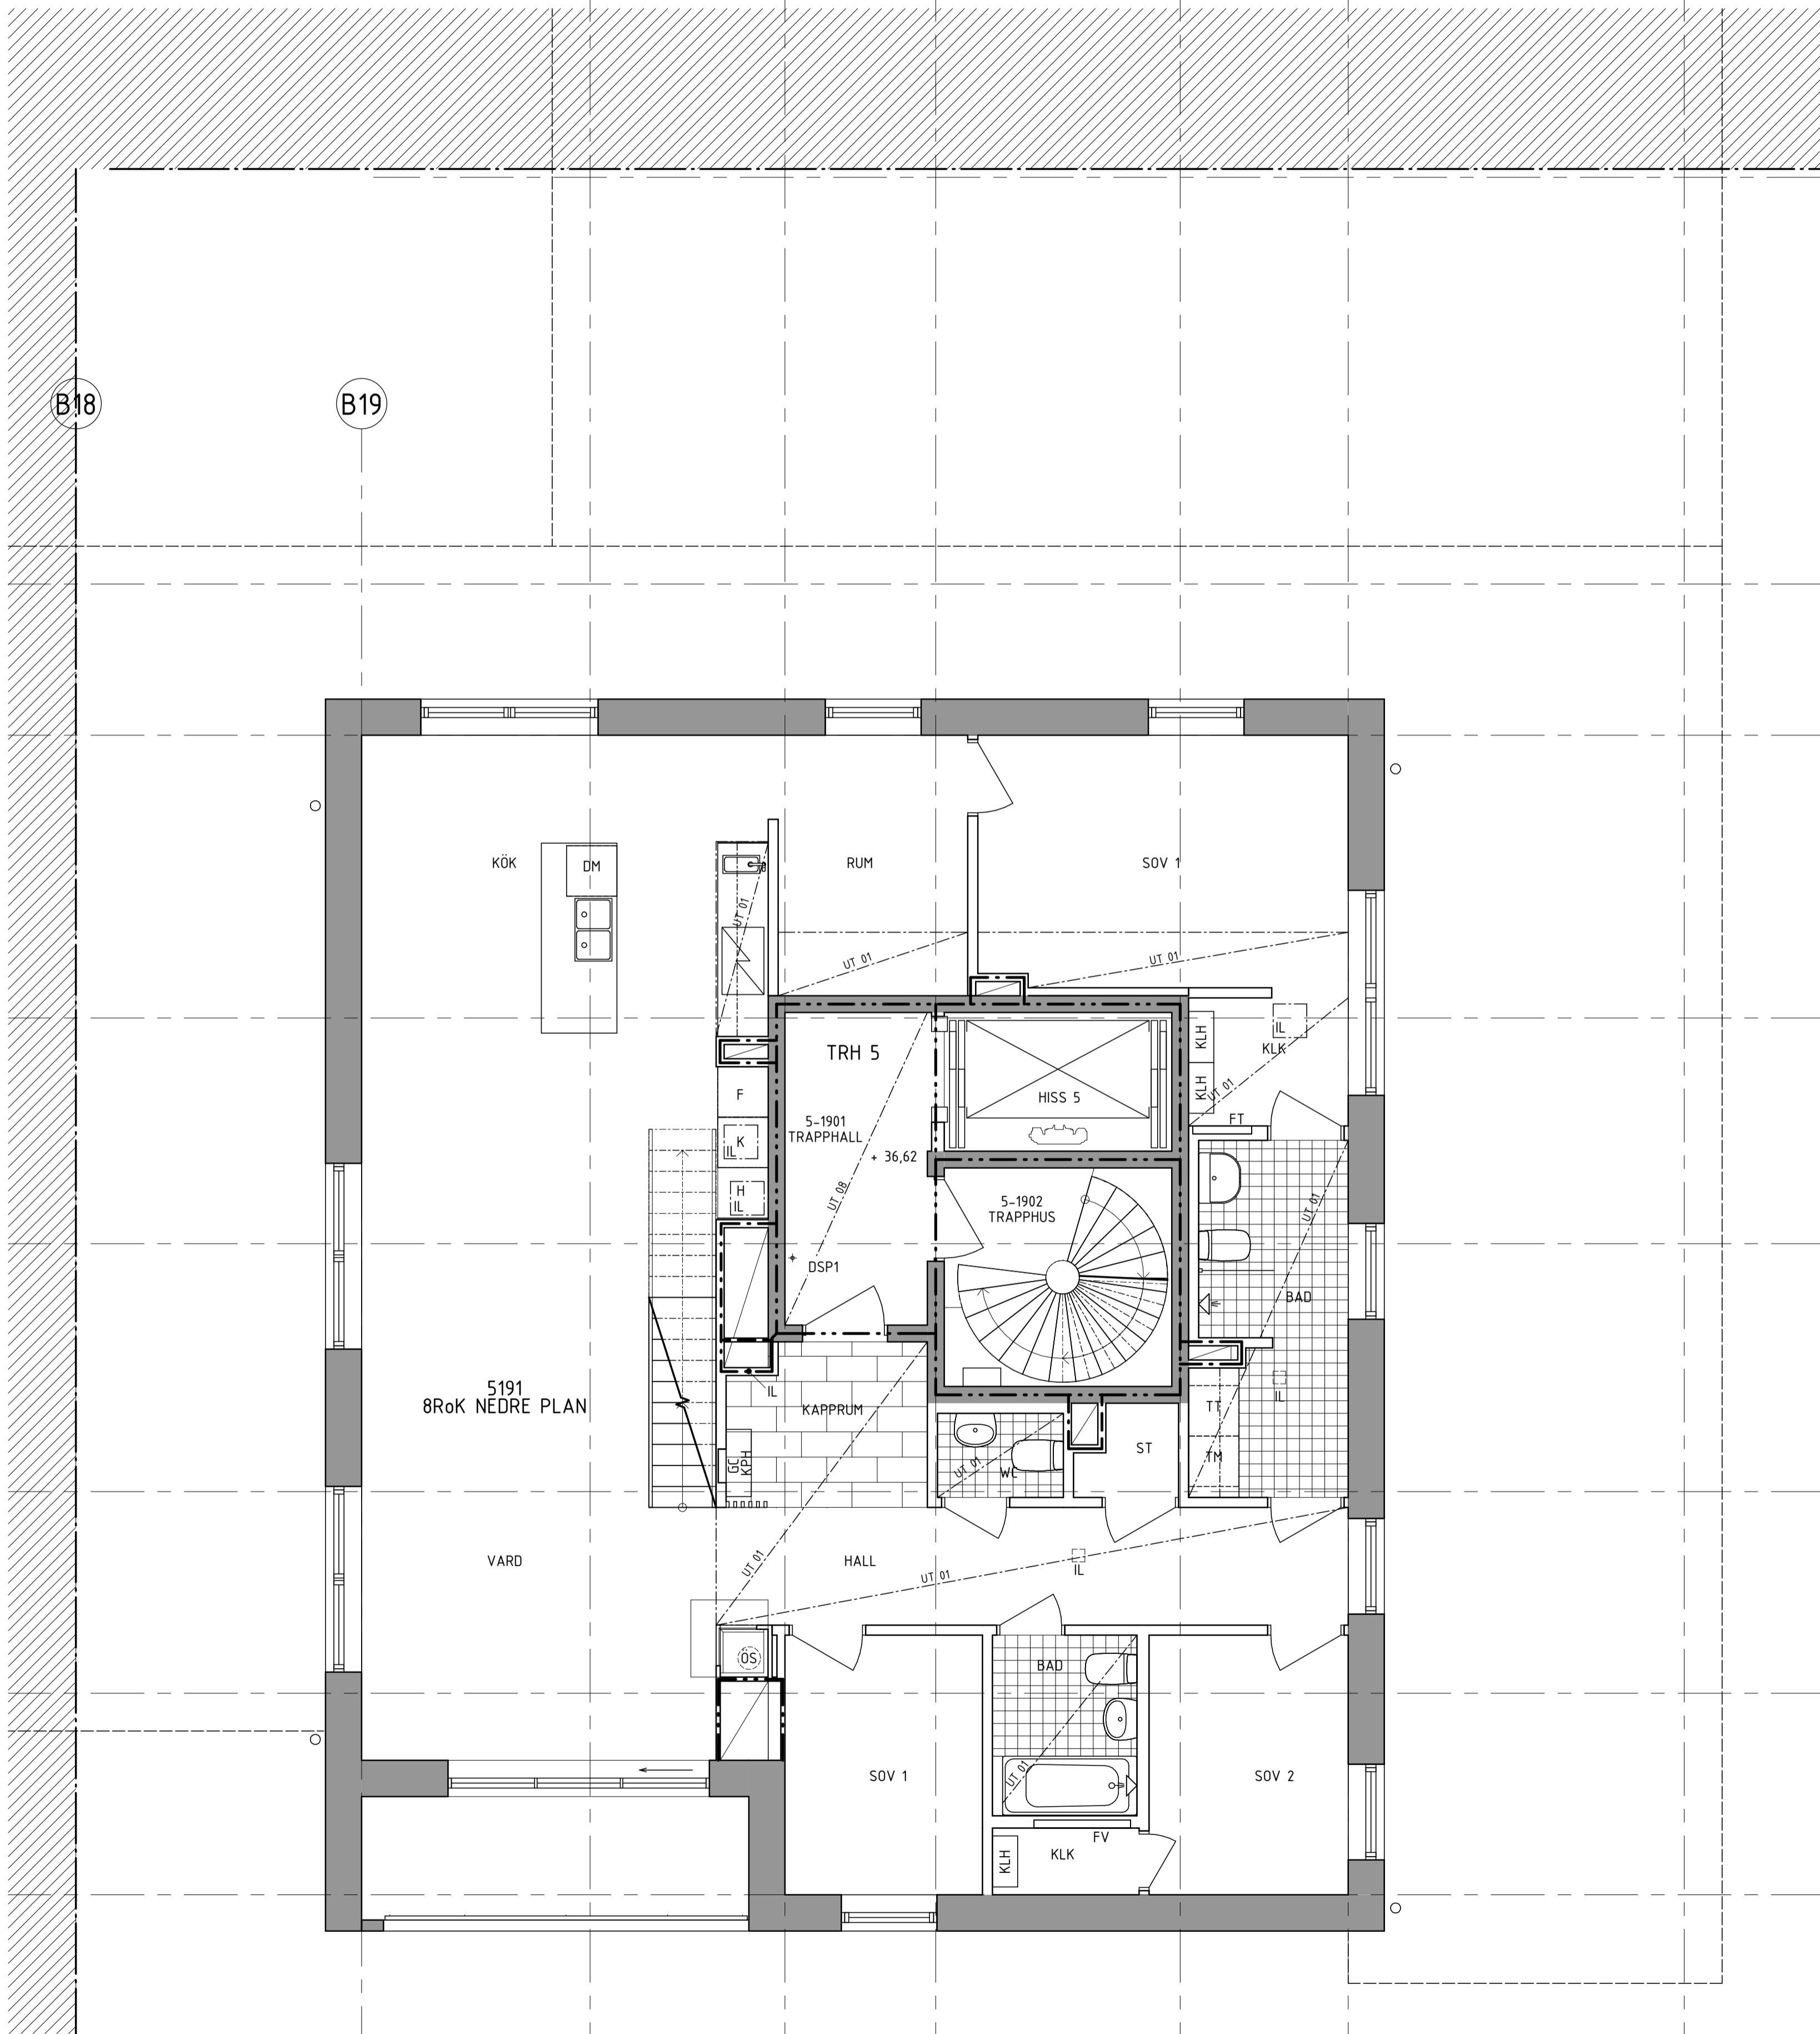

5191
8RoK NEDRE PLAN

VARD

HALL

SOV 1

SOV 2

KÖK

RUM

SOV 1

TRH 5

HISS 5

5-1902 TRAPPHUS

BAD

KAPPRUM

ST

ST


KLH

KLK

FV

BET ANT ANDRINGEN AVSER SIGN DATUM

BROFÄSTET B11

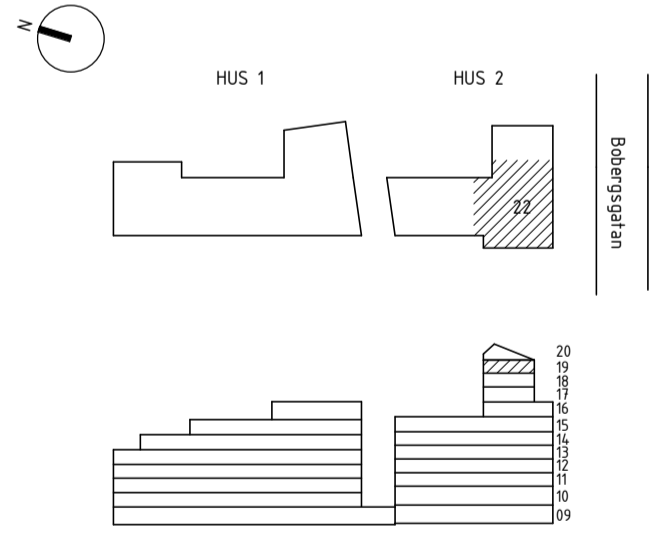


RELATIONSHANDLING

Semrén+Månsson | **TOBIN IPROPERTIES**

| | | |
|---|------------------|--------------------|
| A | SEMRÉN & MÅNSSON | TEL: 08-459 37 00 |
| K | KJAB | TEL: 018-10 03 90 |
| E | IKKAB | TEL: 08-556 965 80 |
| V | PROJEKTENGEMANG | TEL: 08-522 069 00 |
| W | PROJEKTENGEMANG | TEL: 08-522 069 00 |
| L | URBIO | TEL: 08-658 99 38 |

| | | |
|------------|--------------|-------------|
| LUPPROG NR | RITAD AV | HANDLAGGARE |
| 2123 | PL,FB,AE,MA | A EKMAN |
| DATUM | ANSVARIG | |
| 2019-06-07 | ANDERS EKMAN | |

NORRA DJURGÅRDSSTADEN, STOCKHOLM
FLERBOSTADSHUS
HUS 2, PLAN 19, DEL 22

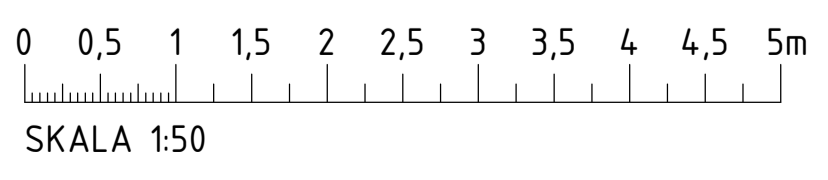

| | | |
|----------|---------------|-----|
| SKALA | NUMMER | BET |
| A1 1:50 | A1-40-1-21922 | |
| A3 1:100 | | |